

RECEIVED  
MAY 29 2012  
COMMISSIONER OF FINANCE

Request for Certification of Sufficient Funds

Submittal Date: 05-29-12

The Department of PUBLIC SAFETY requests certification that sufficient funds are or will be available to cover the claim to meet the following obligation when it becomes due and payable.

Obligation to be incurred, detailing vendor name, project description, Council approval, etc. (attach Documents as necessary):

CAPITAL BUDGET PROJECT #1132 71186  
COVINS Mechanical CHANGE ORDER P-01

Appropriation - Current Budget Expense Org/Object/Proj: #1186 = H3146952-52000-1186

Amount Requested for Approval: \$ 1,200.00 1186

Current Amount Available: \$ ~~35,158.75~~ \$30,358.75

Transfer/Amendment Pending: \$

Transfer/Amendment Date: 6-5-12

Aileen J. Linnan  
Department Head Signature

5/29/12  
Date

Certification of Sufficient Funds

The Commissioner of Finance hereby certifies that funds are or will be available to cover the claim to meet the above described obligation when it becomes due and payable.

Michelle W. Clark-Madigan  
Commissioner of Finance

5/30/12  
Approval Date



# CHANGE ORDER

## City of Saratoga Springs

No. P-01

DATE OF ISSUANCE: 05-14-12

EFFECTIVE DATE: 06-06-12

OWNER: City of Saratoga Springs, New York  
 CONTRACTOR: Collins Mechanical, LLC  
 Contact: Mark Collins, Owner (518)-466-4115  
 Project: Lake Avenue Fire Station  
 OWNER'S Contract No.: 2012-02 ENGINEER'S Contract No.: 10164-1  
 ENGINEER: Engineered Solutions

You are directed to make the following changes in the Contract Documents:

**Description:**

Provide and install one pressure-reducing valve and install owner-supplied water meter.

**Reason for Change Order:**

Field condition - excessive water main pressure.

*CAPITAL BUDGET PROJECT*  
*# 1132/1186*

**Attachments: (List documents supporting change)**

*051412 Price Quotation P-01*

*LAKE AVE FIRE STATION  
INFRASTRUCTURE*

CHANGE IN CONTRACT PRICE:	
Original Contract Price:	\$ <u>105,312.00</u>
Net Increase (Decrease) From Previous Change Orders:	No. <u>0</u> To _____ : \$ _____
Contract Price Prior To This Change Order:	\$ <u>105,312</u>
Net Increase (Decrease) Of This Change Order:	\$ <u>1,200.00</u>
Contract Price With All Approved Change Orders:	\$ <u>106,512</u>

CHANGE IN CONTRACT TIMES:	
Original Contract Times:	Substantial Completion: <u>120</u> Ready For Final Payment: <u>150</u> (days or dates)
Net Change From Previous Change Orders No. _____ To _____	No. _____ :
	Substantial Completion: _____ Ready For Final Payment: _____ (days)
Contract Times Prior To This Change Order:	Substantial Completion: _____ Ready For Final Payment: _____ (days or dates)
Net Increase (Decrease) This Change Order:	Substantial Completion: _____ Ready For Final Payment: _____ (days)
Contract Times With All Approved Change Orders:	Substantial Completion: _____ Ready For Final Payment: _____ (days or dates)

RECOMMENDED:  
By: [Signature]  
ENGINEER (Authorized Signature)

APPROVED:  
By: \_\_\_\_\_  
OWNER (Authorized Signature)

ACCEPTED:  
By: \_\_\_\_\_  
CONTRACTOR (Authorized Signature)

Date: 5-29-12

Date: \_\_\_\_\_

Date: \_\_\_\_\_

# Collins Mechanical, LLC

Plumbing & HVAC

LICENSED MASTER PLUMBERS

153 RUCKYTUCKS ROAD  
STILLWATER, NEW YORK 12170

Chad Reinemann, P.E., LEED AP  
Professional Engineer  
RYAN-BIGGS ASSOCIATES, P.C.  
257 Ushers Road  
Clifton Park, NY 12065

May 14, 2012

Change Order P-01 )QS.DFISFRVFTUIQ.13\*  
Pressure reducing valve and water meter installation  
Lake Ave. Fire House  
60 Lake Avenue  
Saratoga Springs, NY 12866

Provide and install one pressure-reducing valve due to excessive  
water main pressure(85 psi) and install owner-supplied water meter:

Labor: \$285.00  
Material: P.R. Valve \$750.00  
Fittings \$165.00  
Total: \$1200.00



Mark Collins

Request for Certification of Sufficient Funds



Submittal Date: 5-29-12

The Department of PUBLIC SAFETY requests certification that sufficient funds are or will be available to cover the claim to meet the following obligation when it becomes due and payable.

Obligation to be incurred, detailing vendor name, project description, Council approval, etc. (attach Documents as necessary):

CAPITAL BUDGET PROJECT #1132/1186  
LAKE AVE FIRE STATION INFRASTRUCTURE  
P-02 CHANGE ORDER

*Collins Mechanical*

USE: CAPITAL BUDGET PROJECT #1133

Appropriation - Current Budget Expense Org/Object/Proj:

Amount Requested for Approval: \$10,700, — 14314695-52000-1133

Current Amount Available: \$ 58,410, — ✓

Transfer/Amendment Pending: \$

Transfer/Amendment Date: 6-5-12

*[Signature]* 5/29/12  
Department Head Signature Date

Certification of Sufficient Funds

The Commissioner of Finance hereby certifies that funds are or will be available to cover the claim to meet the above described obligation when it becomes due and payable.

*[Signature]*  
Commissioner of Finance

5/30/12  
Approval Date



**CHANGE ORDER**  
**City of Saratoga Springs**

No. P-02

DATE OF ISSUANCE: 05-14-12

EFFECTIVE DATE: 06-06-12

OWNER: City of Saratoga Springs, New York  
 CONTRACTOR: Collins Mechanical, LLC  
 Contact: Mark Collins, Owner (518)-466-4115  
 Project: Lake Avenue Fire Station  
 OWNER'S Contract No.: 2012-02 ENGINEER'S Contract No.: 10164-1  
 ENGINEER: Engineer Solutions

You are directed to make the following changes in the Contract Documents:

Description:

Disconnect existing water service to fire station.

Reason for Change Order:

*Additional plumbing required for work in progress*

*CAPITAL BUDGET PROJECT  
#1132/1186*

Attachments: (List documents supporting change)

*05-14-12 Price Request P-02*

*LAKE AVE FIRE STATION  
INFRASTRUCTURE*

CHANGE IN CONTRACT PRICE:	
Original Contract Price:	\$ <u>105,312.00</u>
Net Increase (Decrease) From Previous Change Orders:	No. <u>1</u> To _____ : \$ _____
Contract Price Prior To This Change Order:	\$ <u>106,512</u>
Net Increase (Decrease) Of This Change Order:	\$ <u>10,700.00</u>
Contract Price With All Approved Change Orders:	\$ <u>117,212</u>

CHANGE IN CONTRACT TIMES:	
Original Contract Times:	Substantial Completion: <u>120</u> Ready For Final Payment: <u>150</u> (days or dates)
Net Change From Previous Change Orders No. _____ To _____	No. _____ :
	Substantial Completion: _____ Ready For Final Payment: _____ (days)
Contract Times Prior To This Change Order:	Substantial Completion: _____ Ready For Final Payment: _____ (days or dates)
Net Increase (Decrease) This Change Order:	Substantial Completion: _____ Ready For Final Payment: _____ (days)
Contract Times With All Approved Change Orders:	Substantial Completion: _____ Ready For Final Payment: _____ (days or dates)

RECOMMENDED:  
By: [Signature]  
ENGINEER (Authorized Signature)

APPROVED:  
By: \_\_\_\_\_  
OWNER (Authorized Signature)

ACCEPTED:  
By: \_\_\_\_\_  
CONTRACTOR (Authorized Signature)

Date: 5-29-12

Date: \_\_\_\_\_

Date: \_\_\_\_\_

**Collins Mechanical, LLC**  
**Plumbing & HVAC**

LICENSED MASTER PLUMBERS

153 RUCKYTUCKS ROAD  
STILLWATER, NEW YORK 12170

Chad Reinemann, P.E., Leed AP  
RYAN-BIGGS ASSOCIATES, P.C.  
257 Ushers Road  
Clifton Park, NY 12065

May 14, 2012

Change Order P. 02 )QS.DFISFRVETUIQ.14\*  
Lake Ave. Firehouse  
60 Lake Ave.  
Saratoga Springs, NY 12866


Disconnect existing water service:  
Labor and equipment: \$10,000.00  
Material: \$700.00  
Total: \$10,700.00

Assuming: That the existing valve operates and the pipe is capable of being capped AND that National Grid will allow excavation in the area of their east iron gas main. If either of these become an issue, we would have to work on a time and material basis.  
(Excavation by William J. Morris Excavating)

Mark Collins



Request for Certification of Sufficient Funds

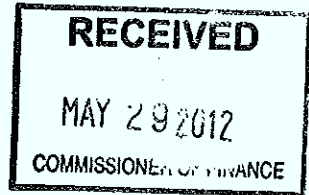

Submittal Date: 05-29-12

The Department of PUBLIC SAFETY requests certification that sufficient funds are or will be available to cover the claim to meet the following obligation when it becomes due and payable.

Obligation to be incurred, detailing vendor name, project description, Council approval, etc. (attach Documents as necessary):

CAPITAL BUDGET PROJECT #1172: BLOOD BORNE PATHOGEN DECONTAMINATION PROJECT  
P-03 CHANGE ORDER

*Collins Mechanical*

Appropriation - Current Budget Expense Org/Object/Proj:

Amount Requested for Approval: \$ 33,165 H3143122-52000112

Current Amount Available: \$ 63,250

Transfer/Amendment Pending: \$

Transfer/Amendment Date: 6/5/12

*Aileen Fineran*  
Department Head Signature

5/29/12  
Date

Certification of Sufficient Funds

The Commissioner of Finance hereby certifies that funds are or will be available to cover the claim to meet the above described obligation when it becomes due and payable.

*Michael Mark Madigan*  
Commissioner of Finance

5/30/12  
Approval Date



CHANGE ORDER
City of Saratoga Springs

No. P-03

DATE OF ISSUANCE: 05-21-12

EFFECTIVE DATE: 06-06-12

OWNER: City of Saratoga Springs, New York
CONTRACTOR: Collins Mechanical, LLC
Contact: Mark Collins, Owner (518)-466-4115
Project: Lake Avenue Fire Station
OWNER'S Contract No.: 2012-02 ENGINEER'S Contract No.: 10164-1
ENGINEER: Engineered Solutions

You are directed to make the following changes in the Contract Documents:

Description:

All plumbing work associated with modifications to shaft infill work as described on Plumbing Contract Price Request #3

Reason for Change Order:

Bloodborne Pathogen OSHA Compliance

CAPITAL BUDGET PROJECT # 1172

Attachments: (List documents supporting change)

05-21-12 Price Request P-03

PR\_P-01.pdf

BLOOD BORNE PATHOGEN

Table with 1 column and 5 rows: CHANGE IN CONTRACT PRICE. Original Contract Price: \$105,312.00. Net Increase (Decrease) From Previous Change Orders: No. 2. Contract Price Prior To This Change Order: \$117,212. Net Increase (Decrease) Of This Change Order: \$33,165.00. Contract Price With All Approved Change Orders: \$150,377.

Table with 1 column and 5 rows: CHANGE IN CONTRACT TIMES. Original Contract Times: Substantial Completion: 120, Ready For Final Payment: 150. Net Change From Previous Change Orders No. To. Contract Times Prior To This Change Order: Substantial Completion: Ready For Final Payment: (days or dates). Net Increase (Decrease) This Change Order: Substantial Completion: Ready For Final Payment: (days). Contract Times With All Approved Change Orders: Substantial Completion: Ready For Final Payment: (days or dates).

RECOMMENDED: By: [Signature] ENGINEER (Authorized Signature)

APPROVED: By: [Signature] OWNER (Authorized Signature)

ACCEPTED: By: [Signature] CONTRACTOR (Authorized Signature)

Date: 5-29-12

Date:

Date:

# Collins Mechanical, LLC

Plumbing & HVAC

LICENSED MASTER PLUMBERS

153 RUCKYTUCKS ROAD  
STILLWATER, NEW YORK 12170


Chad Reinemann, P.E., Leed AP  
RYAN-BIGGS ASSOCIATES, P.C.  
257 Ushers Rd.  
Clifton Park, NY 12065

May 21, 2012

Change Order PO 3      )QS.DFISFRVFTUIQ.12\*  
Hose Tower Work  
Lake Ave. Firehouse  
60 Lake Ave.  
Saratoga Springs, NY 12866

- 1.) Install duplex sewage pump system
    - a. Pump System- \$2800.00
    - b. Saw-cut and patch existing basement floor-\$2380.00
    - c. Excavate and set basin and pumps-\$1520.00
  - 2.) Sanitary and vent piping per:  
P004, P005, P006:  
Labor: \$6080.00  
Material:  
    Pipe and fittings-\$3140.00  
    F.D. and CO. F.A. Vent Cover-\$800.00
  - 3.) Hot and Cold Water Piping per:  
P001, P002, P003  
Labor:  
    -- Core decks- \$910.00  
    Hot and cold water piping- \$1520.00  
Material-\$650.00  
Pipe covering-\$850.00
  - 4.) Gas piping:  
Labor- \$1520.00  
Material-\$200.00
  - 5.) Fixtures:  
Ice Machine-\$2375.00  
Two M.B.1- \$4600.00  
One S.1-\$2300.00  
Labor-\$1520.00
- Total: \$33,165.00

  
Mark Collins

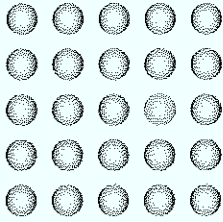

engineeredolutions

73 Troy Rd #2B  
East Greenbush, NY 12061  
Phone: 518.477.6068  
Fax: 518.479.7931

[www.engineered-solutions.net](http://www.engineered-solutions.net)

9 Corporate Drive  
Clifton Park, NY 12065  
Phone: 518.261.6479  
Fax: 518.280.6526

5-5-12

**LAKE AVE FIREHOUSE**

**APPARATUS FLOOR REPLACEMENT AND BASEMENT INFILL**

ES Project #1177; APN none


**PRICE REQUEST:**

**PC CONTRACT PR # 1**

***All original Contract Drawings and Specifications are applicable to this price request.***

- 1) Please provide a separate **COST** proposal with an itemized breakdown for labor and materials for **each** of the following items:
  - a) Provide pricing for plumbing work indicated and specified on sketches PR PC-001, 002, 003, 004, 005 & 006

End of Price Request

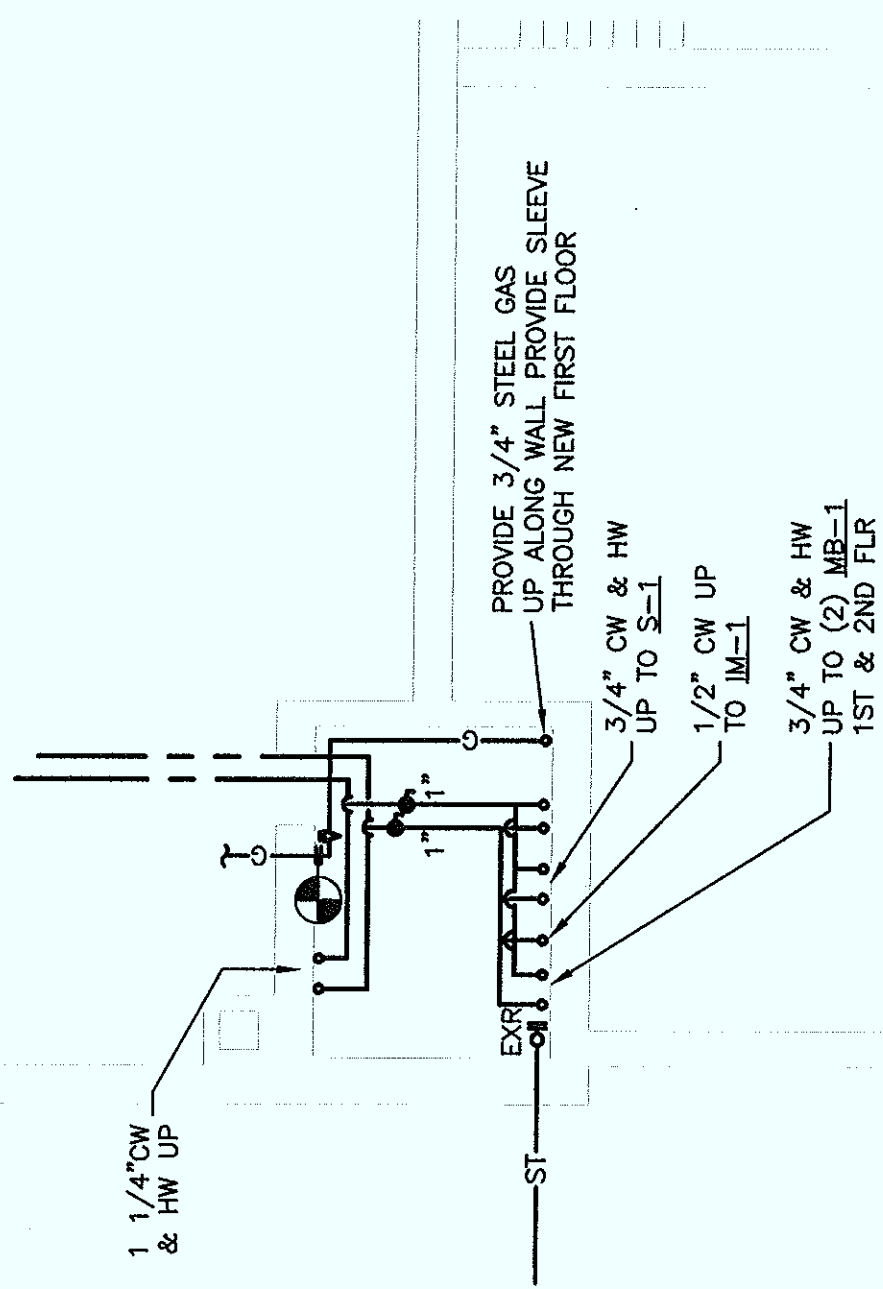

# BASEMENT SUPPLY PIPING PLAN

SCALE: 1/8" = 1'-0"


Engineered Solutions  
 79 Troy Road  
 East Greenbush, NY 12061  
 Tel: (518) 406-5506  
 Fax: (518) 406-5514  
 www.engineered-solutions.net

Electrical  
 Communications  
 Mechanical

BEFORE WORK IS STARTED, CONTRACTOR SHALL VERIFY ALL THE DIMENSIONS AT THE SITE AND IMMEDIATELY NOTIFY THE ARCHITECT OF ALL DISCREPANCIES. ALTERATION OF THIS DOCUMENT BY OTHER THAN AN AUTHORIZED LICENSED PROFESSIONAL ENGINEER IS ILLEGAL AND A VIOLATION OF SECTION 7209 OF THE NEW YORK STATE EDUCATION LAW.

Dwg Number: <b>PR 001</b>	Drawing Title: BASEMENT SUPPLY PIPING PLAN	Revision: Ref. Dwg : P-101	Consultant: <b>RYAN-BIGGS ASSOCIATES, P.C.</b>
	Lake Ave Firehouse APN : 10164   Date : 5-1-12   Dwn by : DAR	<b>LAKE AVENUE FIRE STATION          APPARATUS FLOOR REPLACEMENT          AND BASEMENT INFILL</b> 60 LAKE AVENUE SARATOGA SPRINGS, NEW YORK	P 518 406.5506 F 518 406.5514 www.ryanbiggs.com

© 2012 Ryan-Biggs Associates, P.C.  
 UNAUTHORIZED ALTERATION OF THIS DOCUMENT IS A VIOLATION OF THE NEW YORK STATE EDUCATION LAW.

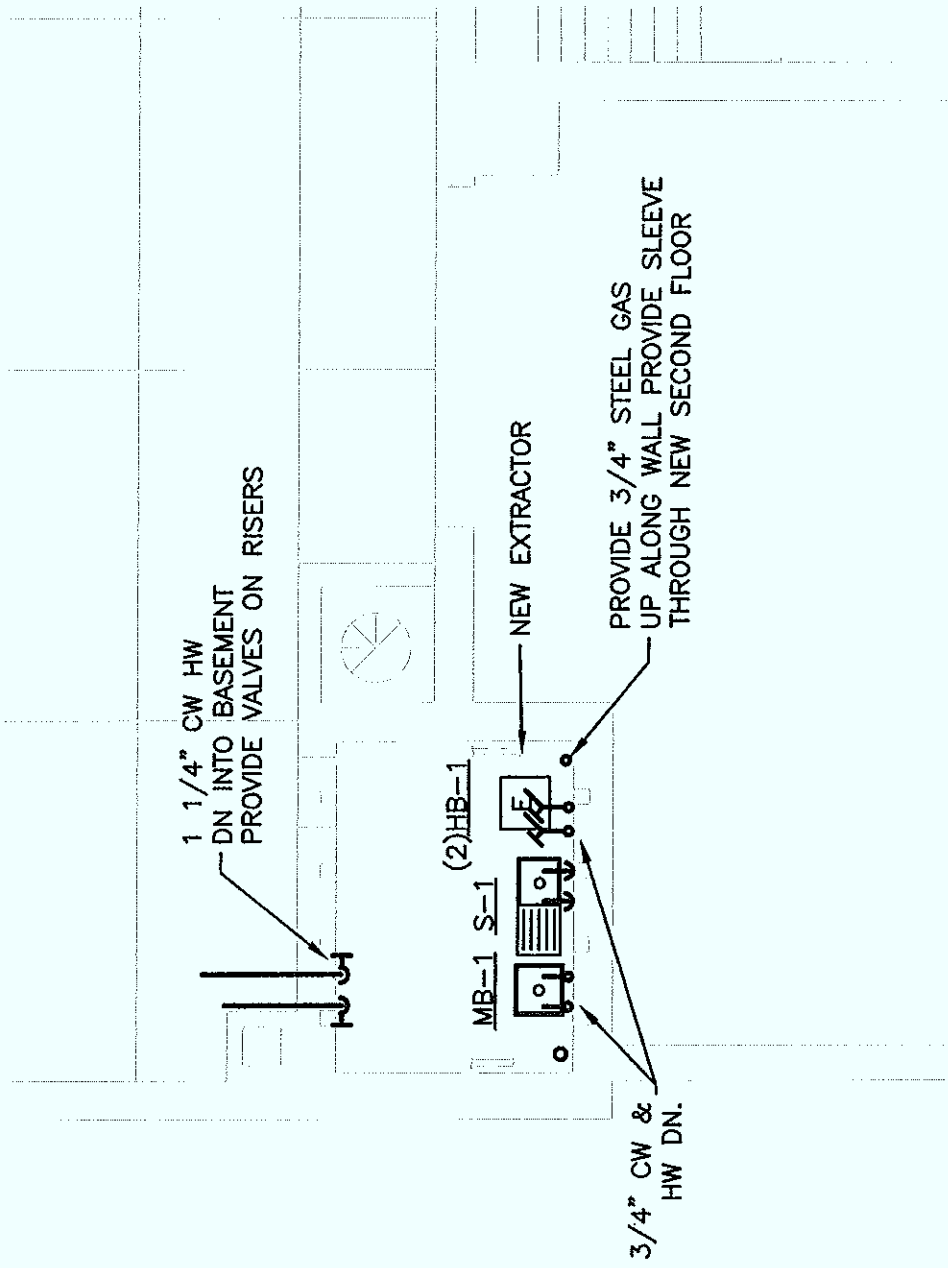

# FIRST FLOOR SUPPLY PIPING PLAN


SCALE: 1/8" = 1'-0"

Engineered Solutions  
 73 Troy Road  
 East Greenbury, NY 12061  
 Tel: (518) 474-7000  
 Fax: (518) 474-7001  
 www.engineered-solutions.net

Electrical  
 Communications  
 Mechanical

BEFORE WORK IS STARTED, CONTRACTOR SHALL VERIFY ALL THE DIMENSIONS AT THE SITE AND IMMEDIATELY NOTIFY THE ARCHITECT OF ALL DISCREPANCIES. ALTERATION OF THIS DOCUMENT BY OTHER THAN AN AUTHORIZED LICENSED PROFESSIONAL ENGINEER IS ILLEGAL AND A VIOLATION OF SECTION 7209 OF THE NEW YORK STATE EDUCATION LAW.

<b>PR</b> <b>002</b>	Drawing Title: <b>FIRST FLOOR SUPPLY PIPING PLAN</b> Ref. Dwg: P-101	Revision:	Consultant: <b>RYAN-BIGGS ASSOCIATES, P.C.</b> 257 Ushers Road Clifton Park, NY 12065 P 518 406.5506 F 518 406.5514 www-ryanbiggs.com	
	Lake Ave Firehouse APN: 10164 Date: 5-1-12 Dwn by: DAR	Lake Avenue Fire Station Apparatus Floor Replacement and Basement Infill 60 Lake Avenue Saratoga Springs, New York	© 2012 Ryan-Biggs Associates, P.C. ALL RIGHTS RESERVED. NO PART OF THIS DOCUMENT IS TO BE REPRODUCED OR TRANSMITTED IN ANY FORM OR BY ANY MEANS, ELECTRONIC OR MECHANICAL, WITHOUT PERMISSION IN WRITING FROM RYAN-BIGGS ASSOCIATES, P.C.	

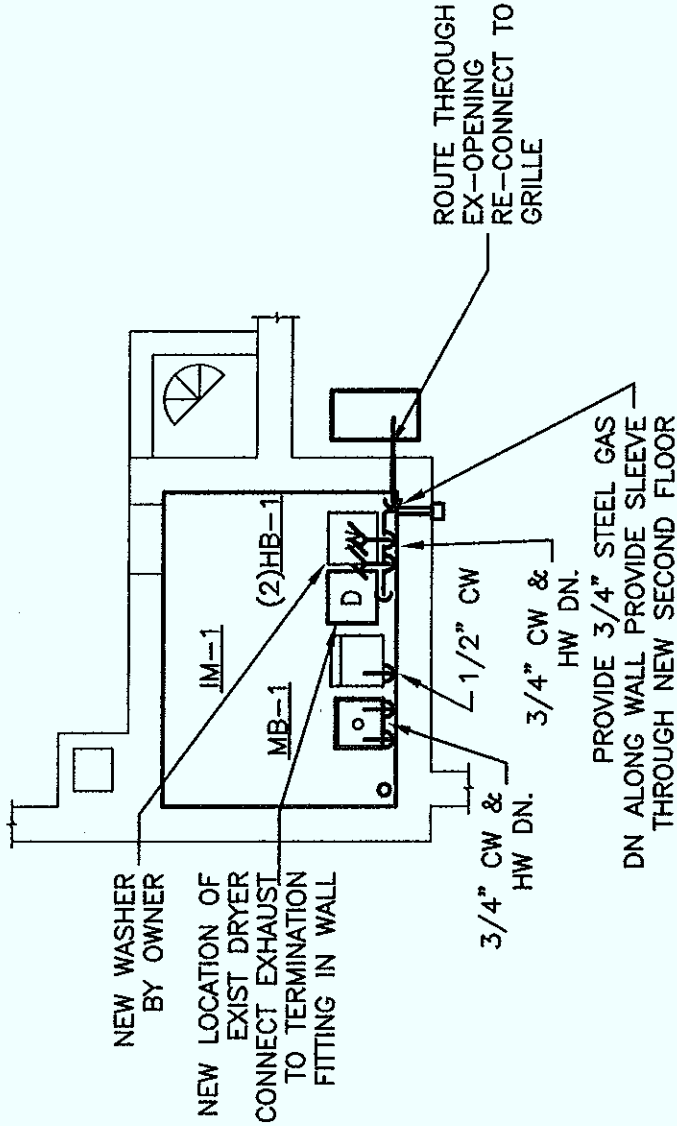

## SECOND FLOOR SUPPLY PIPING PLAN

SCALE: 1/8" = 1'-0"

Engineered Solutions  
 73 Troy Road  
 East Greenbush, NY 12061  
 Tel: (518) 770-7830  
 Fax: (518) 770-7831  
 www.engineered-solutions.net

Electrical  
 Communications  
 Mechanical

www.EngineeredSolutions.com

BEFORE WORK IS STARTED, CONTRACTOR SHALL VERIFY ALL THE DIMENSIONS AT THE SITE AND IMMEDIATELY NOTIFY THE ARCHITECT OF ALL DISCREPANCIES. ALTERATION OF THIS DOCUMENT BY OTHER THAN AN AUTHORIZED LICENSED PROFESSIONAL ENGINEER IS ILLEGAL AND A VIOLATION OF SECTION 7209 OF THE NEW YORK STATE EDUCATION LAW.

Dwg Number:	PR	Dwg Title:	SECOND FLOOR SUPPLY PIPING PLAN	Revision:	
	003	Ref. Dwg:	P-101		
		APN:	10164	Date:	5-1-12
				Dm by:	DAR

**LAKE AVENUE FIRE STATION**  
**APPARATUS FLOOR REPLACEMENT**  
**AND BASEMENT INFILL**  
 60 LAKE AVENUE  
 SARATOGA SPRINGS, NEW YORK


Consultant: **RYAN-BIGGS ASSOCIATES, P.C.**  
 257 Ushers Road  
 Clifton Park, NY 12065  
 P 518 406.5506  
 F 518 406.5514  
 www.ryanbiggs.com

© 2012 Ryan-Biggs Associates, P.C.  
 UNAUTHORIZED ALTERATION OR REPRODUCTION IS PROHIBITED BY THE NEW YORK STATE EDUCATION LAW.



**NOTES:**


1. SAW CUT FLOOR AND LOCATE EXISTING 4" SAN FROM FLOOR DRAINS.
2. INSTALL NEW SLP-1 IN FLOOR CONNECT NEW DRAINAGE AND BASEMENT FLOOR DRAINS INTO SLP-1
3. EXTEND PUMP DISCHARGE TO POINT INDICATED.
4. SEE SKETCH PR-005 FOR SPECIFICATIONS

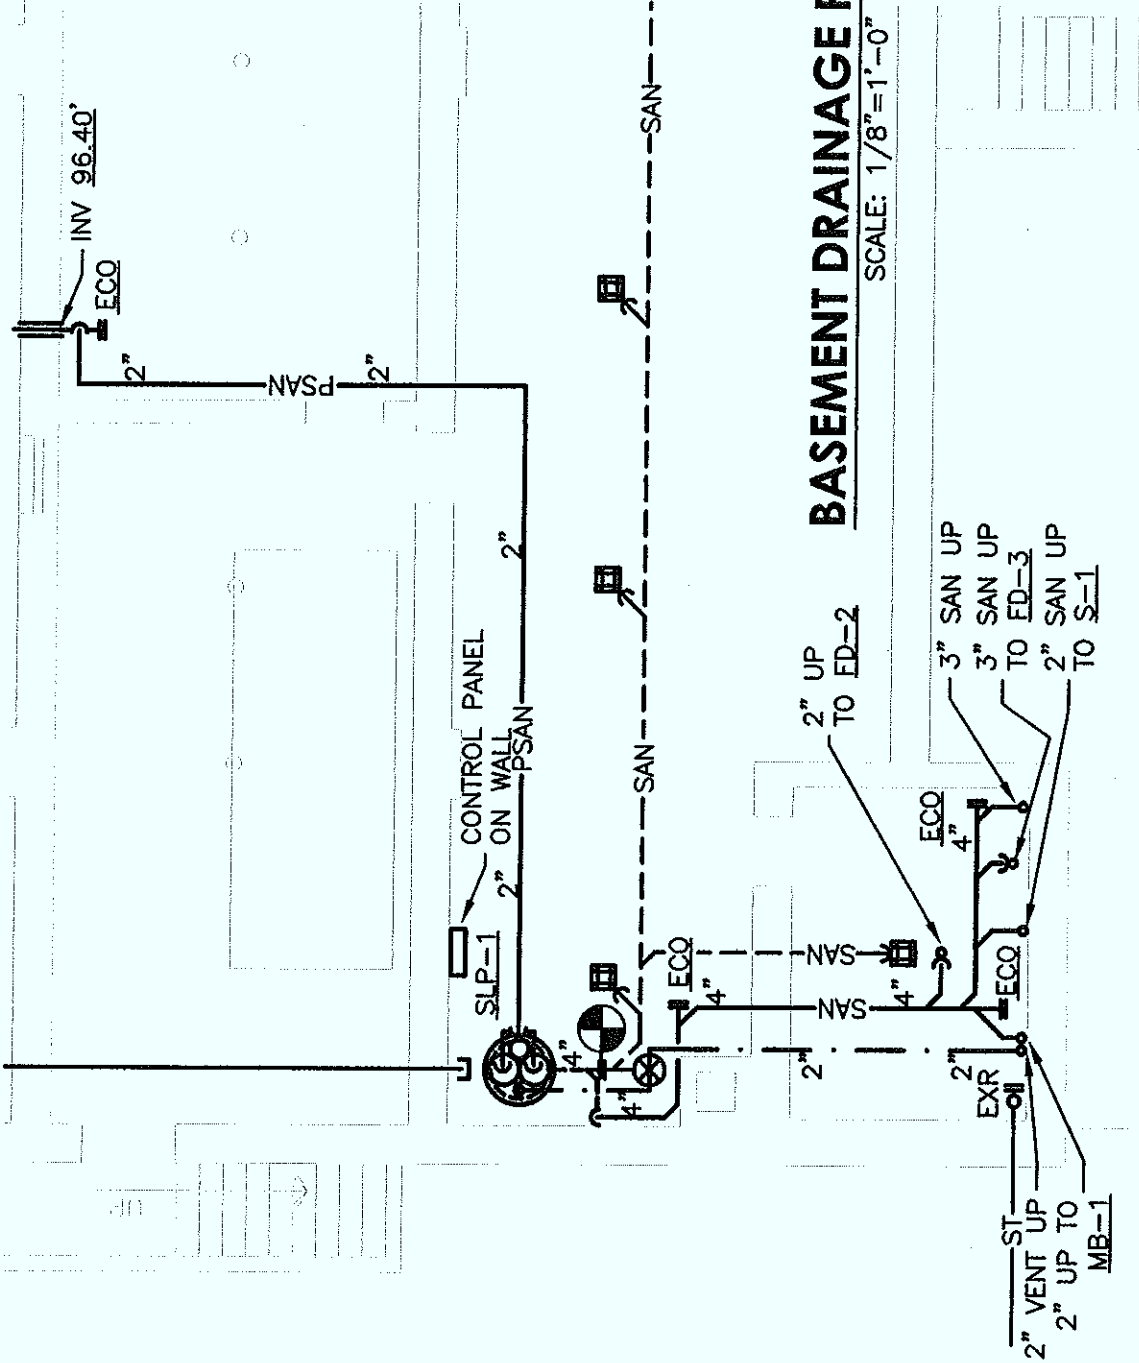

**BASEMENT DRAINAGE PIPING PLAN**

SCALE: 1/8" = 1'-0"

Engineered Solutions  
7317y Road  
Fairport, NY 12061  
Phone: (518) 477-4069  
Fax: (518) 478-7031  
www.engineered-solutions.net

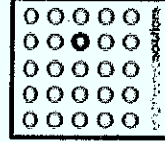

Electrical  
Communications  
Mechanical

BEFORE WORK IS STARTED, CONTRACTOR SHALL VERIFY ALL THE DIMENSIONS AT THE SITE AND IMMEDIATELY NOTIFY THE ARCHITECT OF ALL DISCREPANCIES. ALTERATION OF THIS DOCUMENT BY OTHER THAN AN AUTHORIZED LICENSED PROFESSIONAL ENGINEER IS ILLEGAL AND A VIOLATION OF SECTION 7209 OF THE NEW YORK STATE EDUCATION LAW.

<p>Dwg Number: <b>PR 004</b></p>	<p>Drawing Title: BASEMENT DRAINAGE PIPING PLAN</p>	<p>Revision: Ref. Dwg: P-201</p>	<p>Consultant: <b>RYAN-BIGGS ASSOCIATES, P.C.</b></p>
	<p>APN: 10164 Date: 5-1-12</p>	<p>DRM by: DAR</p>	<p>257 Ushers Road Clifton Park, NY 12065 p 518 406.5506 f 518 406.5514 www.ryanbiggs.com</p>
<p><b>LAKE AVENUE FIRE STATION APPARATUS FLOOR REPLACEMENT AND BASEMENT INFILL</b> 60 LAKE AVENUE SARATOGA SPRINGS, NEW YORK</p>			
<p>© 2012 Ryan-Biggs Associates, P.C. UNAUTHORIZED ALTERATION OR REPRODUCTION OF THIS DOCUMENT IS A VIOLATION OF THE NEW YORK STATE EDUCATION LAW.</p>			



# SPECIFICATIONS


**SLP-1**  
 LIBERTY PUMPS PRE ASSEMBLED DUPLEX SEWAGE SYSTEM 1102/LE51M. 4" INLET 2" DISCHARGE PRE-ASSEMBLED WITH DISCHARGE PUMPS, PIPE, AND FLOATS PRE MOUNTED IN BASIN. BASIN HDPE POLYETHYLENE STRUCTURAL FOAM, 30" X 36" DEEP 110 GALLONS, 4" CAST IRON INLET HUB, COVER HEAVY DUTY 1/4" PLATE STEEL ENAMEL COATED 34" DIA (2) 2" DISCHARGES AND VENT FLANGE. (2) 16" PUMP ACCESS OPENINGS AND ONE 10" INSPECTION COVER, PUMPS SHALL BE LE51M 1/2 HP 115 VOLTS 1PH, 40 GPM @ 15" TDH. CONTROL PANEL AE21L=3 DUPLEX CONTROL PANEL 120 VOLT 1 PH NEMA 1 ENCLOSURE 3 FLOATS 0-14.9 FLA.

**S-1**  
 ADVANCE TABCO # 93-1-24-24L 16 GA 304 SS K-1 8"OC 12" SPOUT FAUCET, K-15 TWIST HANDLE DRAIN W/OVERFLOW, PROVIDE STOPS SUPPLY RSERS AND WASTE OUTLET PIPING INCLUDING 2" P-TRAP.

**MB-1**  
 ADVANCE TABCO # 93-1-24-24L 16 GA 304 SS K-1 8"OC 12" SPOUT FAUCET, K-15 TWIST HANDLE DRAIN W/OVERFLOW, PROVIDE STOPS SUPPLY RSERS AND WASTE OUTLET PIPING INCLUDING 2" P-TRAP.

Engineered Solutions  
 23 Troy Road  
 Saratoga Springs, NY 12061  
 Phone: (518) 477-4088  
 Fax: (518) 478-7931  
 www.engineered-solutions.net

Electrical  
 Communications  
 Mechanical

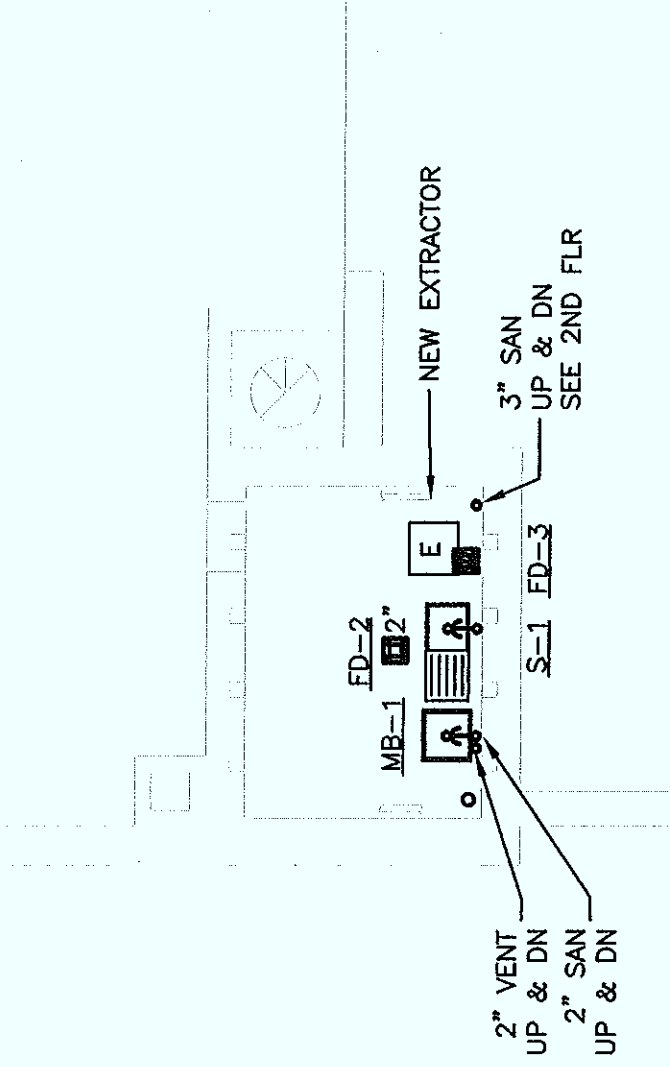

## FIRST FLOOR DRAINAGE PIPING PLAN

SCALE: 1/8"=1'-0"

BEFORE WORK IS STARTED, CONTRACTOR SHALL VERIFY ALL THE DIMENSIONS AT THE SITE AND IMMEDIATELY NOTIFY THE ARCHITECT OF ALL DISCREPANCIES. ALTERATION OF THIS DOCUMENT BY OTHER THAN AN AUTHORIZED LICENSED PROFESSIONAL ENGINEER IS ILLEGAL AND A VIOLATION OF SECTION 7209 OF THE NEW YORK STATE EDUCATION LAW.

Dwg Number: <b>PR 005</b>	Drawing Title: FIRST FLOOR DRAINAGE PIPING PLAN	Revision: Revision:	Consultant: <b>RYAN-BIGGS ASSOCIATES, P.C.</b>
	Ref. Dwg: P-201 LAKE AVE FIREHOUSE	Date: 5-1-12 Dm by: DAR	257 Ushers Road Clifton Park, NY 12065 P 518 406 5506 F 518 406 5514 www.ryanbiggs.com
APN: 10164		60 LAKE AVENUE SARATOGA SPRINGS, NEW YORK	
© 2012 Ryan-Biggs Associates, P.C. AUTHORIZED ALTERATION OR ADDITION TO THIS DOCUMENT IS A VIOLATION OF THE NEW YORK STATE EDUCATION LAW.			


# SPECIFICATIONS

**FD-3**

ZURN Z-326 INDIRECT WASTE FUNNEL, 4" DIA DURA COATED CAST IRON BODY AND BOTTOM OUTLET. PROVIDE TRAP ON BASE.

**IM-1**

PROVIDE MANITOWOC QD--0132A UNDERCOUNTER ICE MACHINE 135 LB PRODUCTION 80 LB STORAGE. FLOOR MOUNTED PROVIDE WITH 3M CUNO CFS717 WATER FILTER SYSTEM. 120 VOLTS POWER CORD WITH NEAM 5-15P PLUG 7.0 AMPS ENERGY STAR RATED.

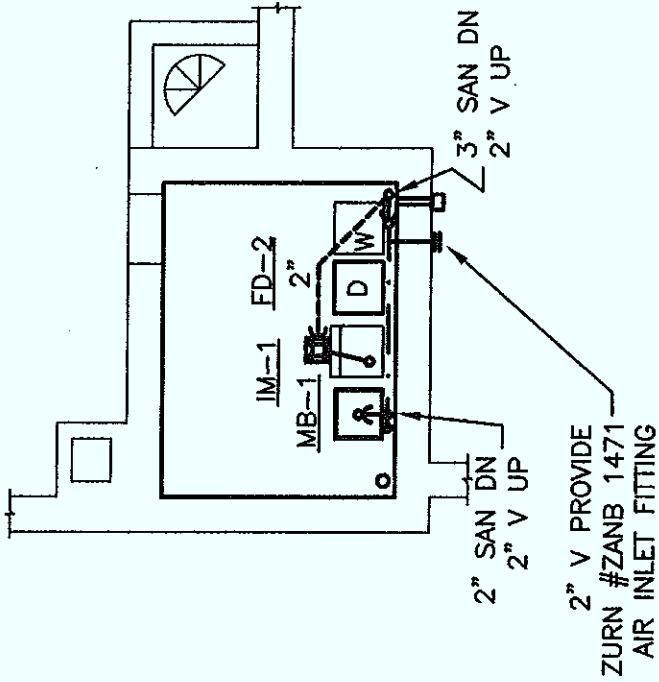

## SECOND FLOOR DRAINAGE PIPING PLAN

SCALE: 1/8"=1'-0"

BEFORE WORK IS STARTED, CONTRACTOR SHALL VERIFY ALL THE DIMENSIONS AT THE SITE AND IMMEDIATELY NOTIFY THE ARCHITECT OF ALL DISCREPANCIES. ALTERATION OF THIS DOCUMENT BY OTHER THAN AN AUTHORIZED LICENSED PROFESSIONAL ENGINEER IS ILLEGAL AND A VIOLATION OF SECTION 7209 OF THE NEW YORK STATE EDUCATION LAW.

Drawing Title: <b>SECOND FLOOR DRAINAGE PIPING PLAN</b>	Ref. Dwg: P-201	Revision:	<b>LAKE AVENUE FIRE STATION APPARATUS FLOOR REPLACEMENT AND BASEMENT INFILL</b> 60 LAKE AVENUE SARATOGA SPRINGS, NEW YORK
Dwg Number: <b>PR 006</b>	Lake Ave Firehouse APN: 10164   Date: 5-1-12	Dm by: DAR	Consultant: <b>RYAN-BIGGS ASSOCIATES, P.C.</b> 257 Usbars Road Clifton Park, NY 12065 P 518 406-5506 F 518 406-5514 WWW.RYANBIGGS.COM

Engineered Solutions

1000 West 10th Street  
 Clifton Park, NY 12065  
 Phone: (518) 477-6083  
 Fax: (518) 479-7051  
 www.engineered-solutions.net

Electrical  
 Communications  
 Mechanical



© 2012 Ryan-Biggs Associates, P.C.  
 ALL RIGHTS RESERVED. NO PART OF THIS DOCUMENT IS TO BE REPRODUCED OR TRANSMITTED IN ANY FORM OR BY ANY MEANS, ELECTRONIC OR MECHANICAL, WITHOUT PERMISSION IN WRITING FROM RYAN-BIGGS ASSOCIATES, P.C.